

# FEELEY/ BACK COTTAGE RENOVATION

36 DEPOT ST  
DENNIS PORT, MA

- REVISION 4/  
05.14.25
- REVISION 3/  
REDUCED LIVING SPACE  
01.15.25
- REVISION 2  
07.24.24
- REVISION 1  
05.15.24

INITIAL ISSUE  
04.19.24

**CLIENT:**

James Feeley  
36 Depot Street  
Dennis Port, MA  
james.a.feeley@gmail.com

**ENGINEERING:**




Michele Cudilo, P.E.  
123 Cottonwood Lane  
Centerville, MA 02632-1979  
mcudilo@comcast.net  
508-737-8521

JOB# / 2023 - 294

**ARCHITECTURAL & STRUCTURAL DRAWINGS:**

Yoana K. Guzman  
5 Madison Ct  
Nantucket, MA 02554  
yoana.ackdesign@gmail.com  
774-325-6705

**FLOOR PLAN & ELEVATIONS**

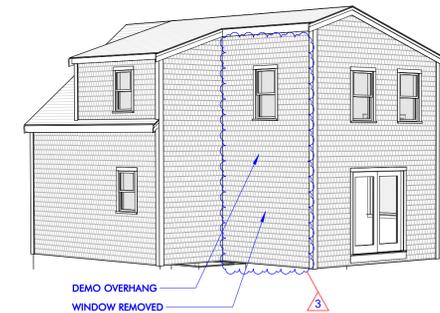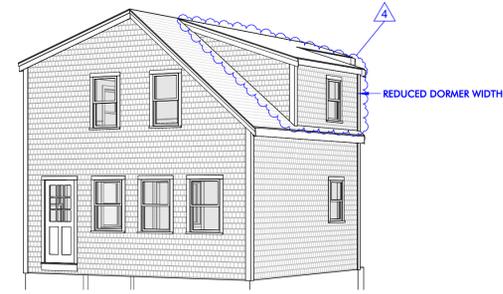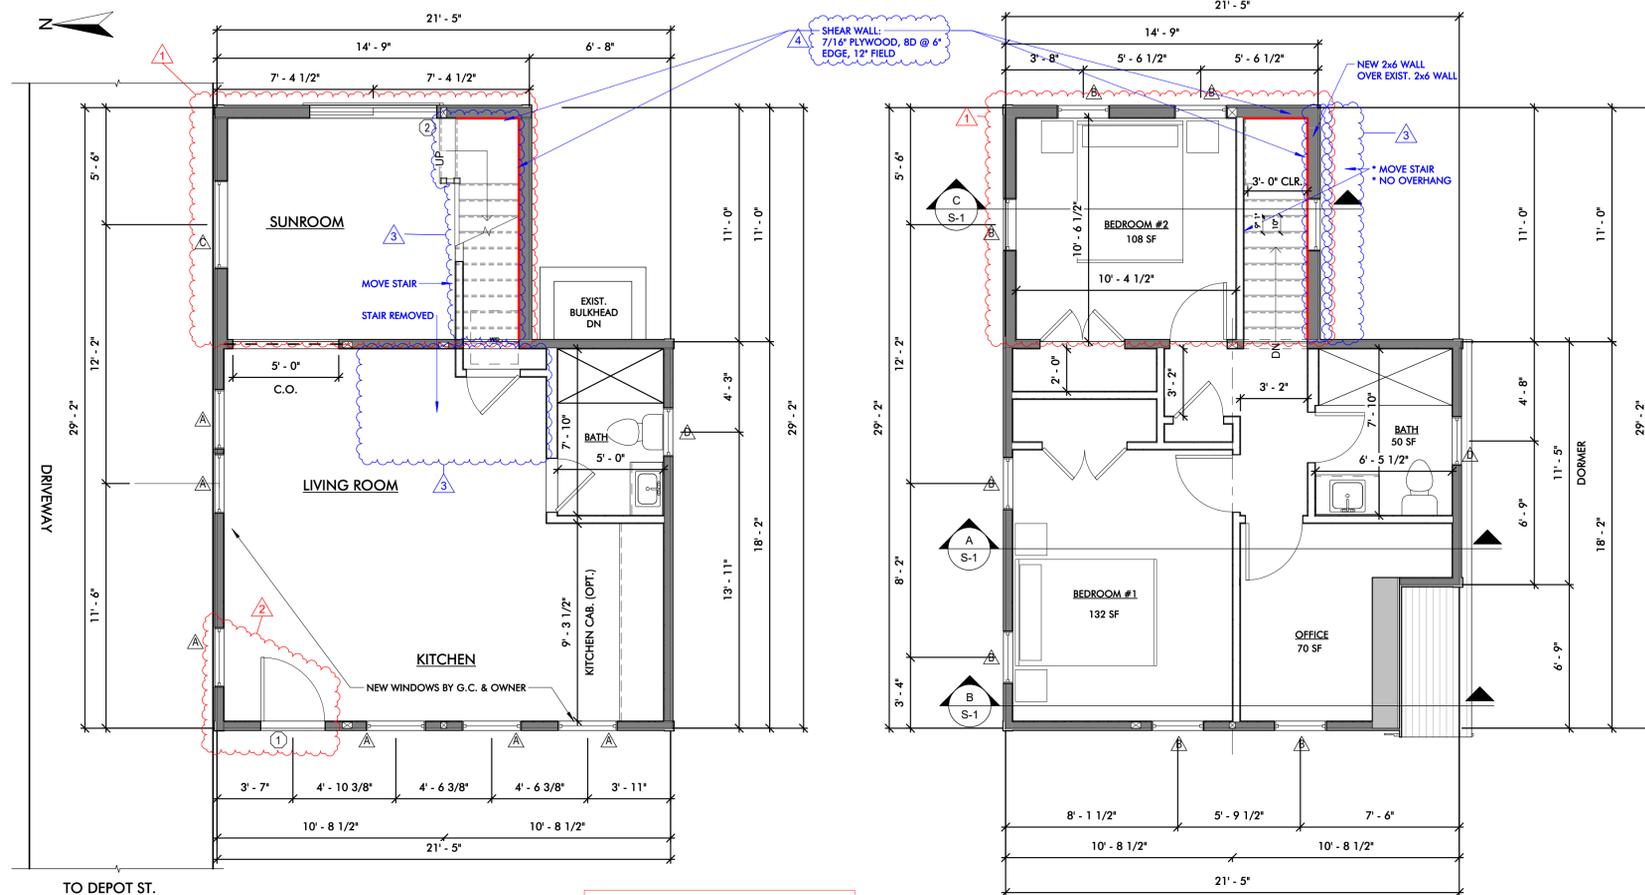

EXTERIOR DOOR SCHEDULE						
DOOR	QUANTITY	WIDTH	HEIGHT	DESCRIPTION	MODEL	FINISH
1	1	3'-0"	6'-8"	SINGLE SWING	TBD	
2	1	6'-0"	6'-8"	DBL GLIDER	TBD	

WINDOW SCHEDULE						
WINDOW	QUANTITY	WIDTH	HEIGHT	DESCRIPTION	MODEL	FINISH
A	6	2'-8"	4'-0"	DH	TBD	
B	8	2'-4"	4'-0"	DH	TBD	
C	1	4'-0"	4'-0"	PIC	TBD	
D	2	2'-2"	3'-4"	DH	TBD	


**NOTES:**

- Contractor to Verify ALL Rough Openings Per Manufacturer Specification PRIOR to Framing
- ALL Doors & Windows to be Installed Per Manufacturer Specification
- It is the Contractor's Responsibility to Ensure that at Least One Window in Each Bedroom has An Egress Window
- Provide Tempered Glass in All Locations Required by Code
- All Ganged Window Units to be Constructed w/ Stud Pockets Between Units


**BUILDING #2**  
 1ST FLOOR: 541 SF  
 2ND FLOOR: 485 SF  
 TOTAL BLDG#2: 1026 SF  
  
 TOTAL BLDG #1: 822 SF  
 TOTAL BOTH BLDGS: 1848 SF  
 PROPERTY: 5050 SF

**1 PROPOSED FIRST FLOOR**  
1/4" = 1'-0"


**2 PROPOSED SECOND FLOOR**  
1/4" = 1'-0"

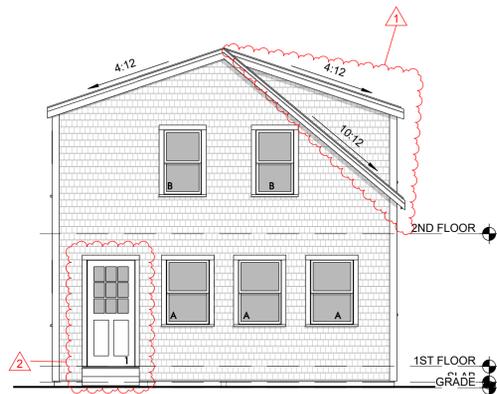


**3 PROPOSED WEST ELEVATION**  
3/16" = 1'-0"

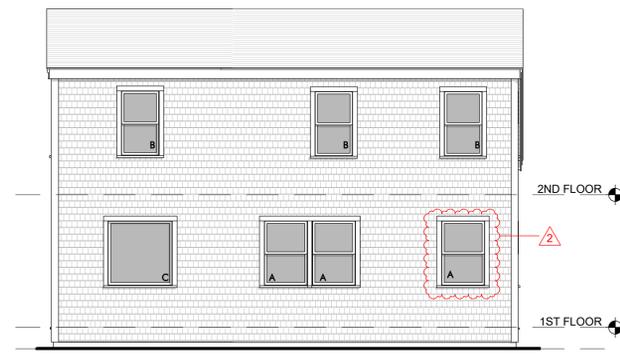

**4 PROPOSED NORTH (DRIVEWAY) ELEVATION**  
3/16" = 1'-0"

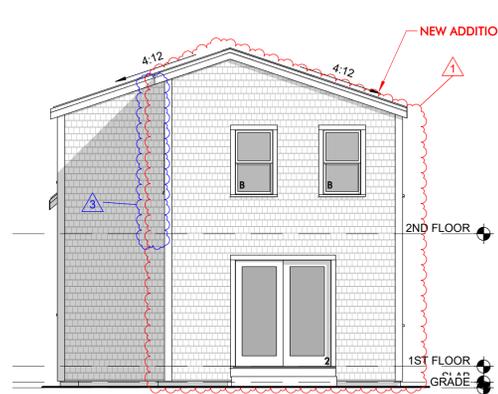

**5 PROPOSED EAST ELEVATION**  
3/16" = 1'-0"

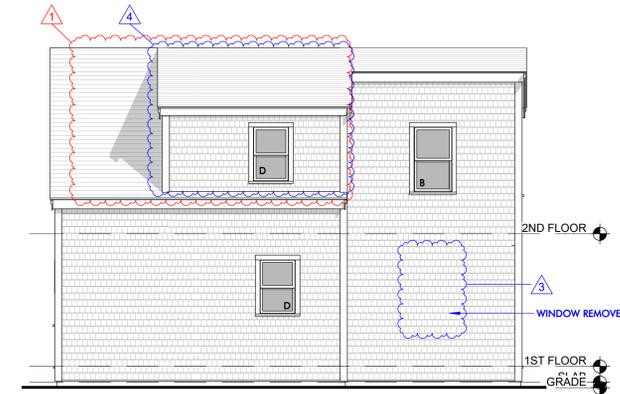

**6 PROPOSED SOUTH ELEVATION**  
3/16" = 1'-0"

# FEELEY/ BACK COTTAGE RENOVATION

36 DEPOT ST  
DENNIS PORT, MA

REVISION 4/  
05.14.25  
REVISION 3/  
REDUCED LIVING SPACE  
01.15.25  
REVISION 2  
07.24.24  
REVISION 1  
05.15.24

INITIAL ISSUE  
04.19.24

CLIENT:

James Feeley  
36 Depot Street  
Dennis Port, MA  
james.a.feeley@gmail.com

ENGINEERING:

Michele Cudilo, P.E.  
123 Cottonwood Lane  
Centerville, MA 02632-1979  
mcudilo@comcast.net  
508-737-8521



FOR STRUCT. ONLY  
05.14.25


JOB# / 2023 - 294

ARCHITECTURAL &  
STRUCTURAL DRAWINGS:

Yoana K. Guzman  
5 Madison Ct  
Nantucket, MA 02554  
yoana.ackdesign@gmail.com  
774-325-6705

FRAMING PLANS  
& SECTIONS

# S-1

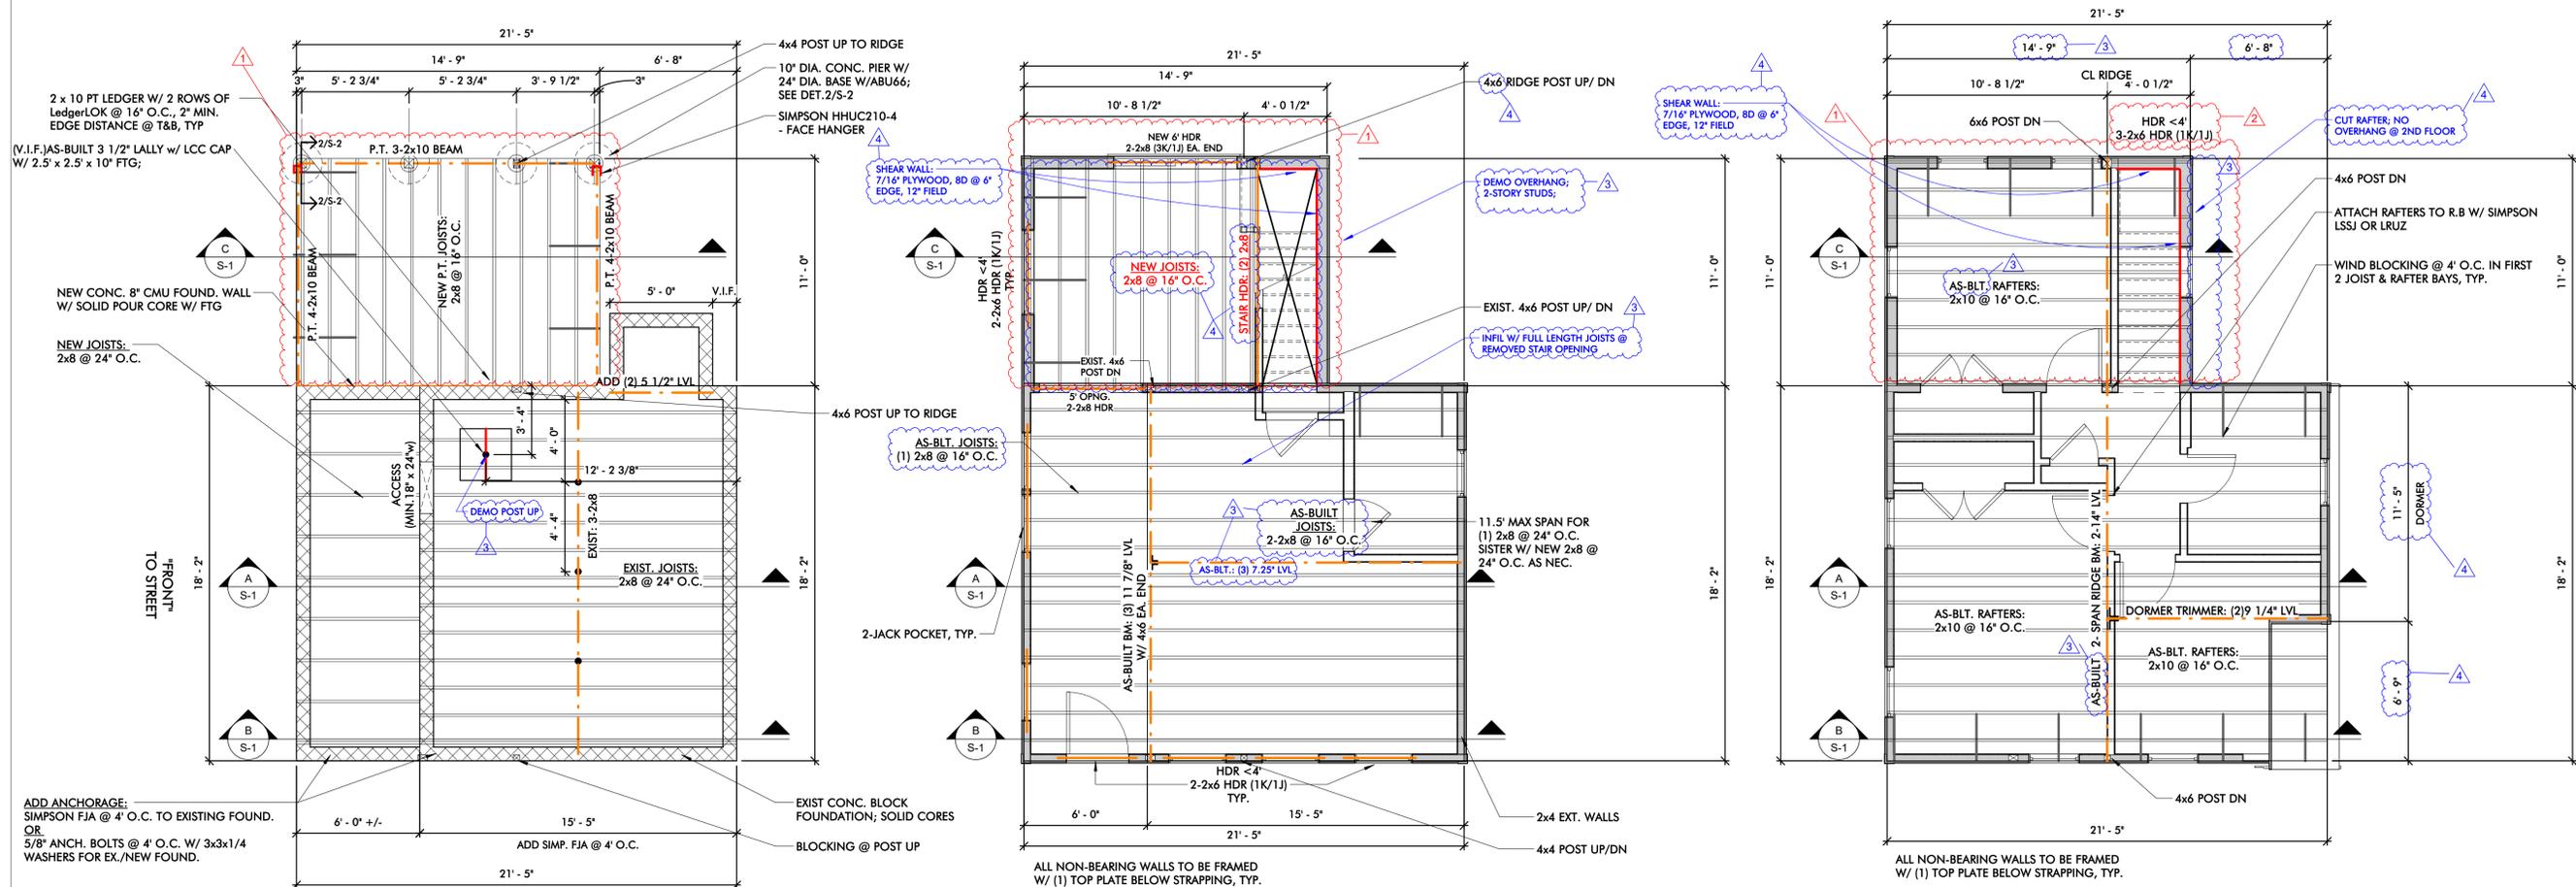


**1 AS-BUILT 1ST FLOOR FRAMING/ FOUNDATION PLAN**  
1/4" = 1'-0"

**2 2ND FLOOR FRAMING PLAN**  
1/4" = 1'-0"

**3 ROOF FRAMING PLAN**  
1/4" = 1'-0"

**ROOF:**  
- Asphalt Shingles, 5" Exp.  
- 30 Lb. Felt  
- 9/16" Plywood Sheathing w/ 8D @ 6" o.c. Edge,  
6" o.c. Field  
- See Framing Plan for Rafter Size & Spacing  
- R49 Insulation

**WALL:**  
- White Cedar Shingles, 5" Exp.  
- 30 Lb. Felt  
- Vert. 7/16" Plywood Sheathing w/  
8D @ 3" o.c. Edge/ 12" o.c. Field  
- 2x4 Studs @ 16" o.c.  
- R21 Insulation, or  
- 1/2" Gypsum, Interior  
Balloon Frame Gable Walls

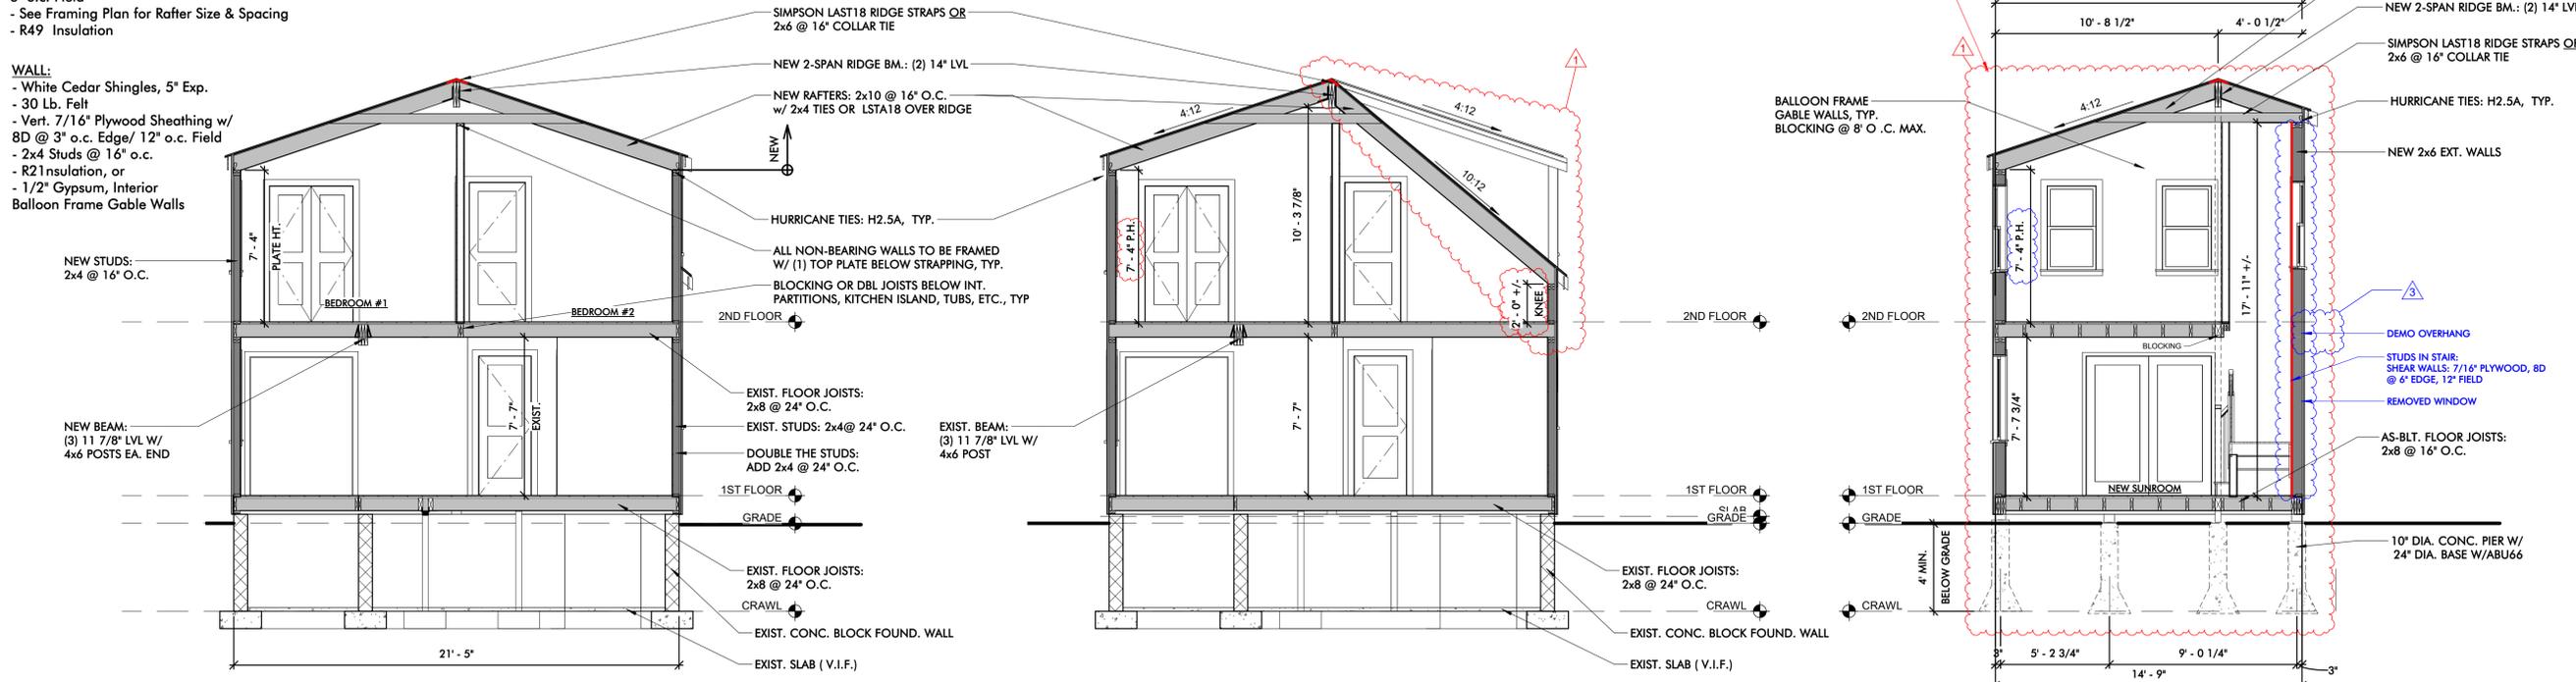

**A SECTION A**  
1/4" = 1'-0"


**B SECTION B**  
1/4" = 1'-0"

**C SECTION C**  
1/4" = 1'-0"


**Multiple-Member Connections for Top-Loaded Beams**

Ply	Fastener		O.C. Spacing	Location
	Type <sup>(1)</sup>	Min. Length		
2	10d nails	3"	3 <sup>rd</sup>	12"
	12d-16d nails	3 1/2"	2 <sup>nd</sup>	
	Screws	3 3/8" or 3 1/2"	2	24"
3	10d nails	3"	3 <sup>rd</sup>	12"
	12d-16d nails	3 1/2"	2 <sup>nd</sup>	
	Screws	3 3/8" or 3 1/2"	2	24"
4	10d nails <sup>(1)</sup>	3"	3 <sup>rd</sup>	12"
	12d-16d nails <sup>(2)</sup>	3 1/2"	2 <sup>nd</sup>	
	Screws	5" or 6"	2	24"
3 1/2"	Screws	5" or 6"	2	24"
	1/2" bolts	8"	2	24"

(1) 10d nails are 0.128" diameter; 12d-16d nails are 0.148" - 0.162" diameter; screws are SDS, SDW, WS, or Truss-LOK-EWP™.  
 (2) An additional row of nails is required with depths of 14" or greater.  
 (3) When connecting 4-ply members, nail each ply to the other and offset nail rows by 2" from the rows in the ply below.

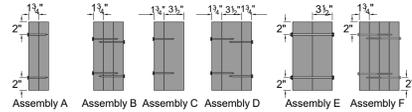

When fasteners are required on both sides, stagger fasteners on the second side so they fall halfway between fasteners on the first side.

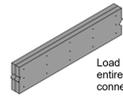

Load must be applied evenly across entire beam width. Otherwise, use connections for side-loaded beams.

Multiple pieces can be nailed or bolted together to form a header or beam of the required size, up to a maximum width of 7"

**MULTIPLE-MEMBER CONNECTIONS FOR WALL STUDS**

**2-PLY NAILING RECOMMENDATIONS**

For 2x4, 13/4" x 51/2", 2x6, 13/4" x 71/4", and 2x8: Minimum of two rows of 16d (0.131" x 31/4") pneumatic nails at 10" on-center, staggered. Nail from one side.

**3-PLY NAILING RECOMMENDATIONS**


For 2x4: Minimum of two rows of 16d (0.131" x 31/4") pneumatic nails at 8" on-center, staggered.

For 13/4" x 51/2", 2x6, 13/4" x 71/4", and 2x8: Minimum of three rows of 16d (0.131" x 31/4") pneumatic nails at 5" on-center, staggered. Nail from both sides.


**4-PLY NAILING RECOMMENDATIONS**

For 2x4: Nail each ply to the other with a minimum of two rows of 16d (0.131" x 31/4") pneumatic nails at 5" on-center. When connecting each ply, offset nail rows by 2" from the ply below.

For 13/4" x 51/2", 2x6, 13/4" x 71/4", and 2x8: Nail each ply to the other with a minimum of three rows of 16d (0.131" x 31/4") pneumatic nails at 5" on-center. When connecting each ply, offset nail rows by 2" from the ply below or Minimum of two rows of 1/2" diameter bolts spaced at 8" o.c.

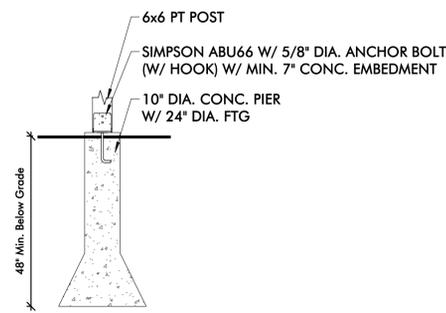


**2 SONOTUBE DETAIL**  
1/2" = 1'-0"

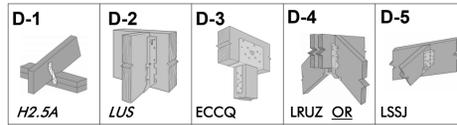

**WOOD STRUCTURAL PANEL (WSP) NOTES:**

Wood Structural Panels Shall be a Minimum Thickness of 7/16" and Be Installed as Follows:

1. Panels Shall Be Installed with Strength Axis Parallel to Studs.
2. All Horizontal Joints Shall Occur Over and Be Nailed to Framing.
3. On Single Story Construction, Panels Shall be Attached to Bottom Plates and Top Member of the Double Top Plate.
4. On Two Story Construction, Panels Shall be Attached to the Top Member of the Upper Double Top Plate and to Band Joist at Bottom of Panel. Upper Attachment of Lower Panel Shall be Made to Band Joist and Lower Attachment Made to Lowest Plate at First Floor Framing.
5. Horizontal Nail Spacing at Double Top Plates, Band Joists, and Girders Shall Be a Double Row of 8D Staggered @ 3 Inches o.c. Per Attached Figures.

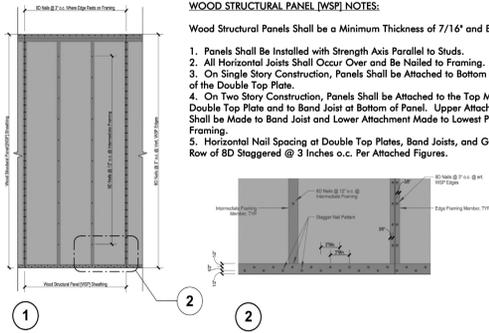

**FEELEY/ BACK COTTAGE RENOVATION**

36 DEPOT ST  
DENNIS PORT, MA

REVISION 4/  
05.14.25  
REVISION 3/  
REDUCED LIVING SPACE  
01.15.25

REVISION 2  
07.24.24

REVISION 1  
05.15.24

INITIAL ISSUE  
04.19.24

**CLIENT:**

James Feeley  
36 Depot Street  
Dennis Port, MA  
james.a.feeley@gmail.com

**ENGINEERING:**

Michele Cudilo, P.E.  
123 Cottonwood Lane  
Centerville, MA 02632-1979  
mcudilo@comcast.net  
508-737-8521



*Michele Cudilo*

FOR STRUCT. ONLY  
05.14.25

JOB# / 2023 - 294

**ARCHITECTURAL & STRUCTURAL DRAWINGS:**

Yoana K. Guzman  
5 Madison Ct  
Nantucket, MA 02554  
yoana.ackdesign@gmail.com  
774-325-6705

**DETAILS**

**S-2**