



EXISTING FRONT ELEVATION

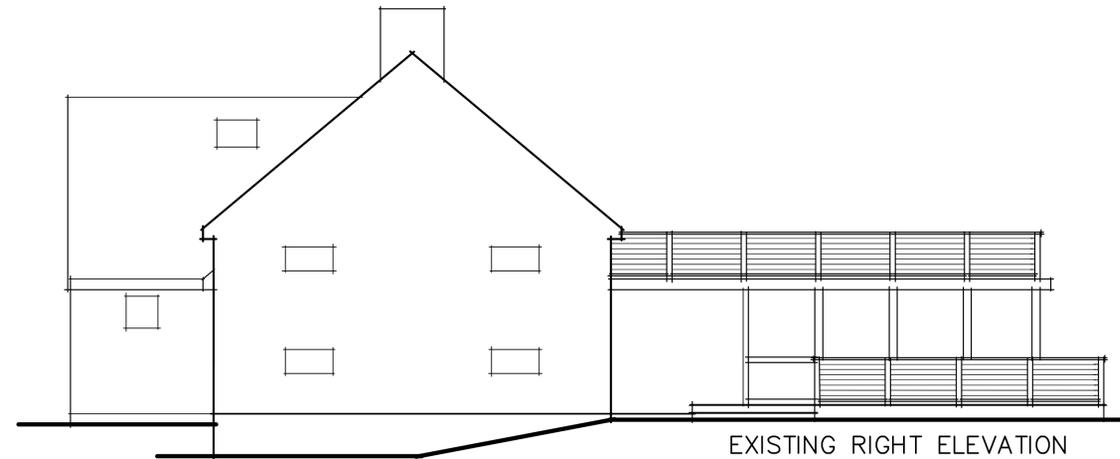


EXISTING RIGHT ELEVATION

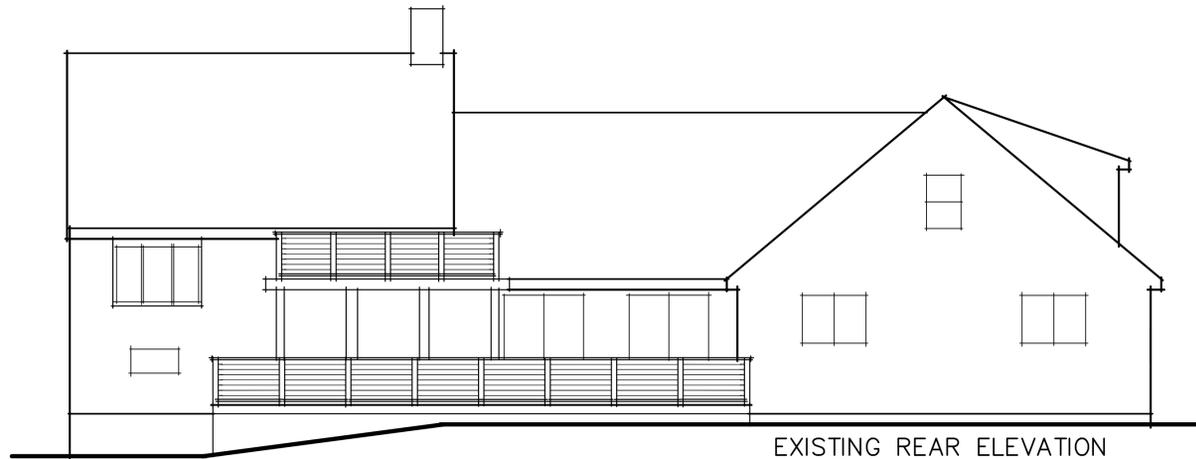

EXISTING REAR ELEVATION




EXISTING LEFT ELEVATION

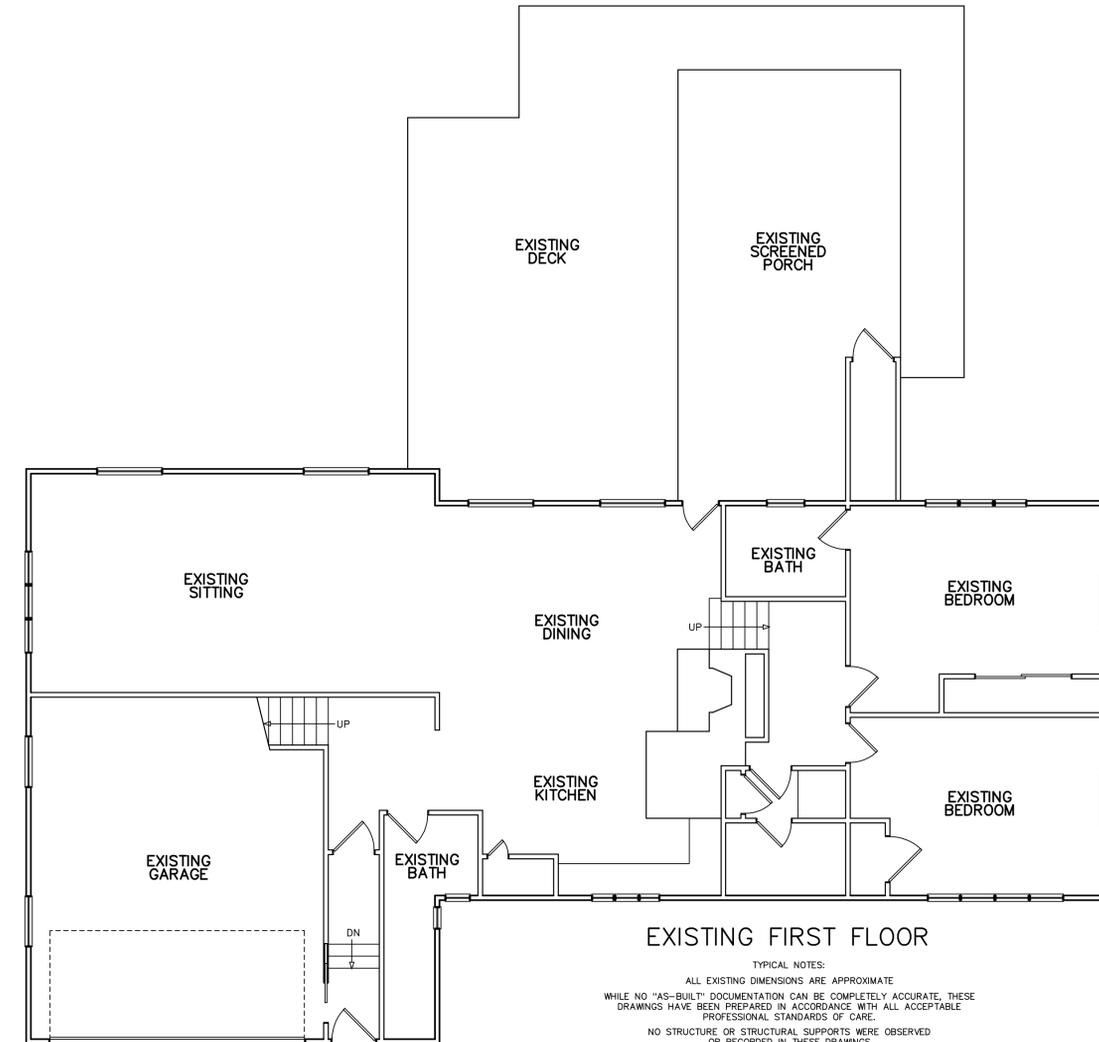

EXISTING FIRST FLOOR

TYPICAL NOTES:
 ALL EXISTING DIMENSIONS ARE APPROXIMATE
 WHILE NO "AS-BUILT" DOCUMENTATION CAN BE COMPLETELY ACCURATE, THESE DRAWINGS HAVE BEEN PREPARED IN ACCORDANCE WITH ALL ACCEPTABLE PROFESSIONAL STANDARDS OF CARE.
 NO STRUCTURE OR STRUCTURAL SUPPORTS WERE OBSERVED OR RECORDED IN THESE DRAWINGS

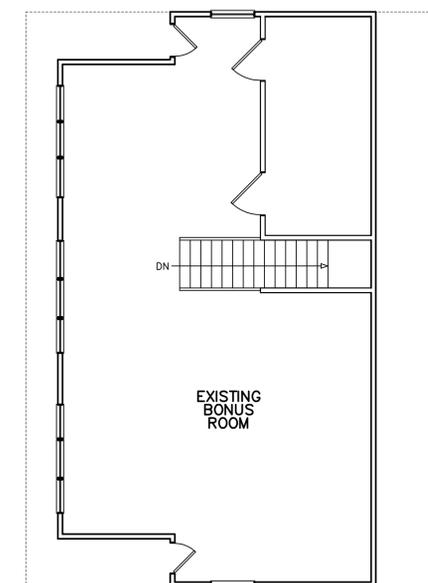

EXISTING SECOND FLOOR



architects interior designers builders
 299 WHITES PATH
 SOUTH YARMOUTH,
 MASSACHUSETTS, 02664
 tel (508) 362 - 8883
 (508) 760 - 2800
 fax (508) 760 - 5800
 WWW.ERTARCHITECTS.COM

EXISTING CONDITIONS AT:
15 ALBION WAY
SOUTH DENNIS, MA
PREPARED FOR:

PROJECT # 180525

© 2025 ERT ARCHITECTS, INC. THE DRAWINGS AND ALL OF THE IDEAS, ARRANGEMENTS, DESIGNS, AND PLANS INDICATED THEREON OR REPRESENTED THEREBY, ARE OWNED BY AND REMAIN THE PROPERTY OF ERT ARCHITECTS, INC. NO PART THEREOF SHALL BE UTILIZED BY ANY PERSON, FIRM, OR CORPORATION FOR ANY PURPOSE, EXCEPT WITH SPECIFIC WRITTEN PERMISSION OF THE FIRM ERT ARCHITECTS, INC.


THESE PLANS ARE NOT TO BE USED FOR PERMITTING OR CONSTRUCTION PURPOSES UNLESS STAMPED & SIGNED WITH AN ORIGINAL ARCHITECT'S STAMP AND SIGNATURE & MARKED AS "PERMIT SET" OR "CONSTRUCTION SET".

REGISTRATION

REVISIONS

DATE:	REVISIONS:

ISSUED FOR:
 DATE:

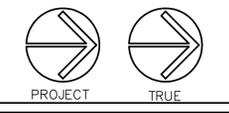

SCALE: 3/16"=1'-0"
 UNLESS OTHERWISE NOTED.

SHEET NO.
EX.1

TOTAL NUMBER OF SHEETS IN SET:
X

THIS SHEET INVALID UNLESS ACCOMPANIED BY A COMPLETE SET OF WORKING DRAWINGS