


LOCUS MAP



HALL STREET

CATCH BASIN

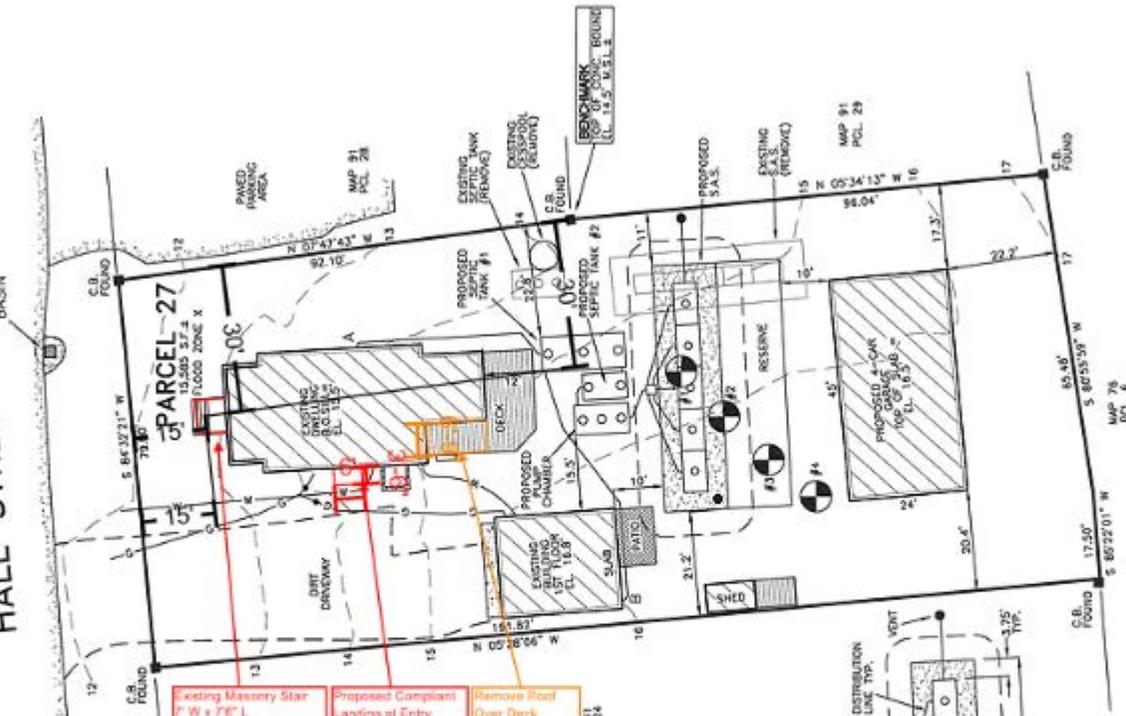


Existing Masonry Stair
7' W x 7'6" L
Proposed Covered Entry
7' W x 8' L

Proposed Compliance
Landing at Entry
3' 6" W x 8' L

Remove Roof
Over Deck
8' 9" W x 12' 3" L

MAP 91
PCL 28

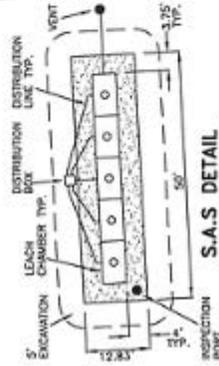

S.A.S. DETAIL

DIRECTY PLAN REFERENCES:
PLAN BOOK 600 PAGE 145 F7
PLAN BOOK 168 PAGE 29
PLAN BOOK 134 PAGE 123
L.C. PLAN #5100, A
PLAN #5100, A
DESIGN PURPOSES ONLY
THIS PLAN IS NOT FOR BOUNDARY
DESCRIPTION PURPOSES AND
CONTRACTORS TO VERIFY
ALL WATER LINES AND GAS
UTILITIES ON PROPERTY.



JASON C. ELLIS, R.S.

J.C. ELLIS DESIGN



P.O. BOX 81
NORTH DASTMA, MA 01861
(508)740-2220
Email: jace@jcellisdesign.com

SEPTIC SYSTEM UPGRADE PLAN

37 HALL STREET
DENNISPORT, MA

PREPARED FOR:
SAO FAMILY PARTNERSHIP LLC
139 RIVERSIDE DRIVE
WEST HARWICH, MA 02671-1511

ASSESSOR'S
MAP 91 PARCEL 27

SCALE: 1"=30'

SHEET 1 OF 2

DATE: FEBRUARY 18, 2004